


THIS PLOT PLAN IS FOR THE PURPOSE OF SHOWING THE HOUSE TO BE CONSTRUCTED ON THE LOT AND MAY NOT REPRESENT THE FINAL AS-BUILT CONFIGURATION OF THE PROPERTY OR IMPROVEMENTS THEREON. THE ACCURACY OF THIS PLOT PLAN IS NOT GUARANTEED, NOR IS IT A PART OF ANY POLICY, REPORT OR GUARANTEE TO WHICH IT MAY BE ATTACHED. ACTUAL DIMENSIONS, OTHER THAN THE MINIMUM ORDINANCE, MAY VARY OR CHANGE WITHOUT PRIOR NOTICE DUE TO ACTUAL SITE CONDITIONS.

NOTE: ALL DOWNSPOUTS WILL BE
CONNECTED TO UNDERGROUND
DRAIN LINES AS REQUIRED BY
THE LOCAL JURISDICTION AND/OR
SOILS REPORT

Leilani Nzau

SIGNATURE

06/07/2024 8:43:42 AM

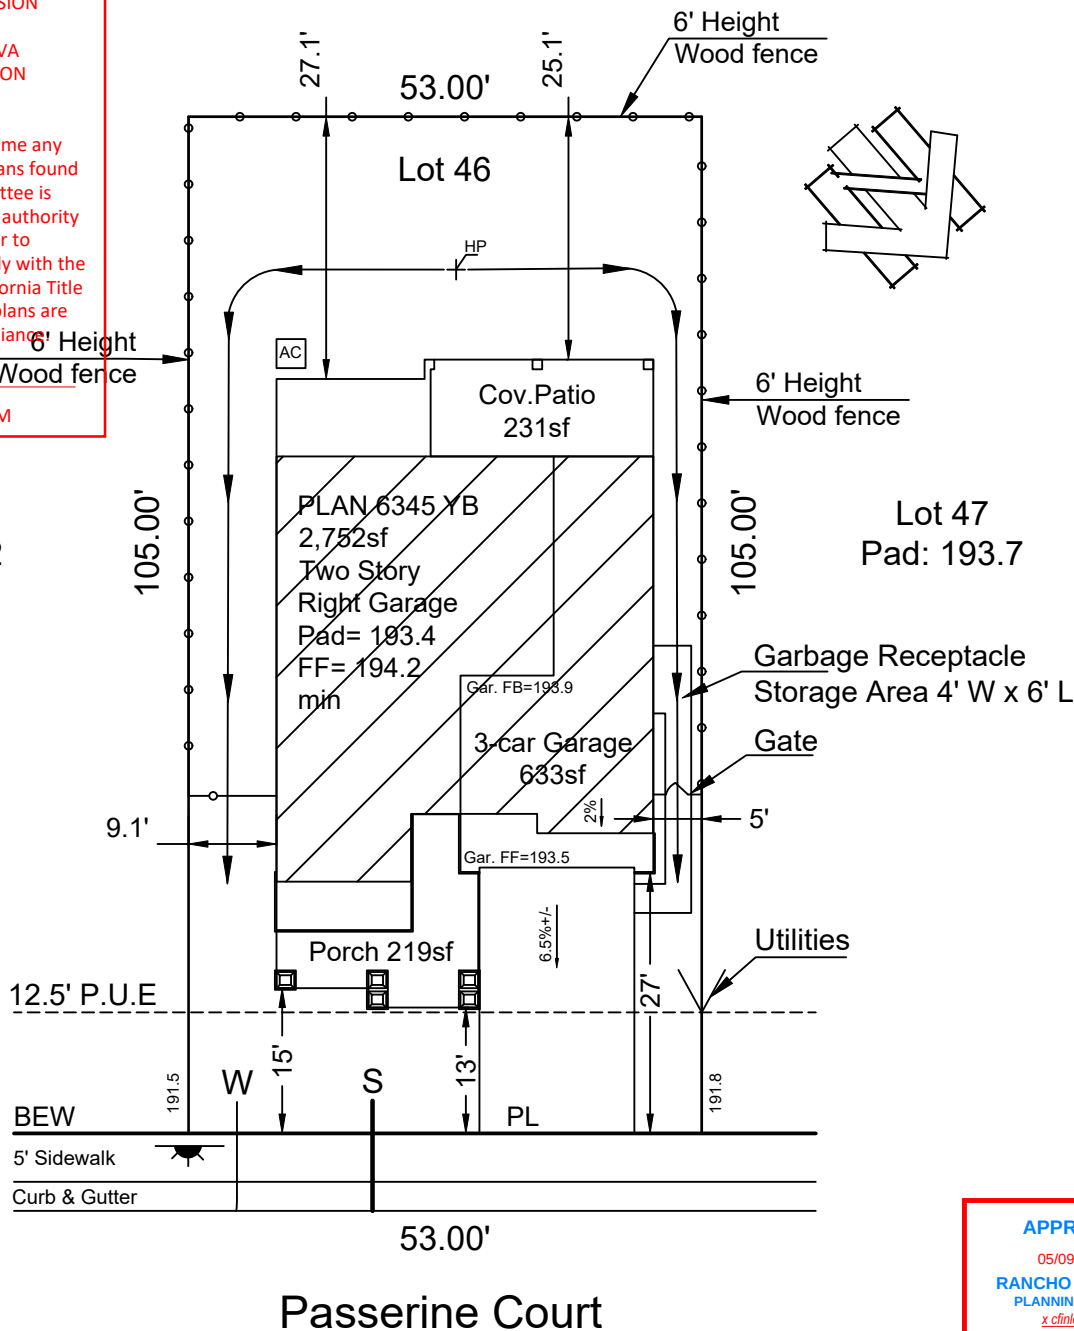

APPROVED

05/09/2024

RANCHO CORDOVA
PLANNING DIVISION
x cfinlevross

PERMIT #587591

**CITY OF RANCHO
CORDOVA**

05/04/2024

Minimum Setbacks:

Front: 18' garage; 12.5' Living area/Porch BEW

Side: Interior 4' min, garage side 5' min;

12.5' street side.

Rear: 15'

Lot Sf: 5,565±

House Footprint: 2,301sf

Lot Coverage: 41.3%

THE RANCH VILLAGE 2

CANYONS @ THE RANCH

Lot #46
12344 Passerine Court
City of Rancho Cordova
A.P.N.: 067-2670-046

	AM	4/18/24	1"=20'
Phase	Drawn By	Date	Scale

Symbols Legend

Wood fence:		Water Service:	
Metal fence:		Sewer Service:	
Masonry		Recy. Wat Serv.:	
Soundwall:		Flow Line	
Street Light:		High Point:	
Drop Inlet:		Flow Line:	
Electric Serv. Box:		Elevation Back	
Fire Hydrant:		of Sidewalk:	
Pad-Mount Transformer:		2nd Story Element:	

KHovnanian
Homes

3721 Douglas Blvd, #150
Roseville, CA 95661
Phone:(916) 945-5400